

Project Name :

South East Zagross Cluster
Sarvestan and Saadat Abad
Oil Fields Project

Drawing Title :

Single Line Diagram OF 400V COMBINED SWITCHGEAR &
MOTOR CONTROL CENTER(M.C.C.)-(SAA2,WELL HEADS,SAADAT ABAD)
(SAA-EE-02-MC-01)

References :

- Electrical Load List , Drawing No.287-50-SS-PE-EL-LL-001
- Key Single Line Diagram Field Manifold &Well Heads, Drawing No.287-50-SS-PE-EL-SD-001-D6
- Typical Schematic/Wiring Diagram, Drawing No.287-50-SS-PE-EL-DG-002-D3
- Specification For Low Voltage Combined Switchgear & Motor Control center , Document No.287-50-SS-PE-EL-SP-003-D2
- Single Line Diagram , Drawing No.287-50-SS-PE-EL-SD-003-D0
- I/O List For Power Distribution control System (PDCS),Document No.287-50-SS-PE-EL-SH-004-D0

Owners and Contractors Comments :

-

Description :

For As Built

ISBs Documents No.:

ISC	37254	SD	0.4	WD	007	01
-----	-------	----	-----	----	-----	----

Client Documents No.:

-

Contractor Documents No.:

287-50-SS-VD-EL-SD-033-D4

Design :

N.Rahmani

Draw :

M.Shahosseini

Date :

16/02/1391

16/02/1391

M-Sh

Check :

Erfan Ezani

Approve :

Erfan Ezani

Date :

18/02/1391


18/02/1391

E-E

Project : South East Zagross Cluster
Sarvestan And Saadat Oil Fields Project

Title : 400V COMBINEDSWITCHGEAR &MOTOR CONTROL CENTER
(M.C.C) - (SAA2,WELL HEADS,SAADAT ABAD) (SAA-EE-02-MC-01)

Drawing Title : SINGLE LINE DIAGRAM

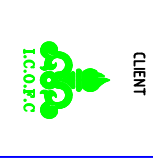



Rev.	Date	Description	Designed by	Checked by	Approved by	Contractor Doc. No.:	Int. Rev.
04	18/02/91	for As Built	N.Rahmani	E.Ezani	E.Ezani	Iran Seabock Doc. No. : ISC-37254-SD-0.4-WD-007-01	-
03	18/07/90	For Approve	N.Rahmani	E.Ezani	E.Ezani	Client Project No. : -	Scale
02	09/07/90	For Approve	N.Rahmani	E.Ezani	E.Ezani	Client Project No. : -	1 : 10
01	19/05/90	For Approve	N.Rahmani	E.Ezani	E.Ezani	Client Doc. No. : -	Sheet
00	25/07/88	For Approve	M.Torfeh	E.Ezani	E.Ezani	Contractor Doc. No. : 287-50-SS-VD-EL-SD-033-D4	1 / 5

SHEET No.	00	01	02	03	04	05	06
1							
2							
SHEET No.	00	01	02	03	04	05	06
26							
27							
SHEET No.	00	01	02	03	04	05	06
51							
52							
Project : South East Zagross Cluster
 Sarvestan And Saader Abad Oil Fields Project
 Title : 400V COMBINEDSWITCHGEAR 4MOTOR CONTROL CENTER
 (M.C.C) - (SAA2,WELL HEADS,SAA0A1 ABAD) (SAA-EE-02-MC-01)
 Drawing Title : SINGLE LINE DIAGRAM

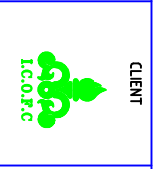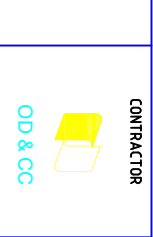


Rev	Date	Description	Designed by	Checked by	Approved by	Contractor Doc. No. :	Int. Rev.
04	18/02/91	for As Built	N.Rahmani	E.Ezani	E.Ezani	Iran Seabock Doc. No. : ISC-37254-SD-04-WD-007-01	-
03	18/07/90	For Approve	N.Rahmani	E.Ezani	E.Ezani	Client Project No. : - Client Doc. No. : -	Scale
02	09/07/90	For Approve	N.Rahmani	E.Ezani	E.Ezani		1 : 10
01	19/05/90	For Approve	N.Rahmani	E.Ezani	E.Ezani		Sheet
00	25/07/88	For Approve	M.Torfeh	E.Ezani	E.Ezani	Contractor Doc. No. : 207-50-SS-VD-EL-SD-033-04	2/5

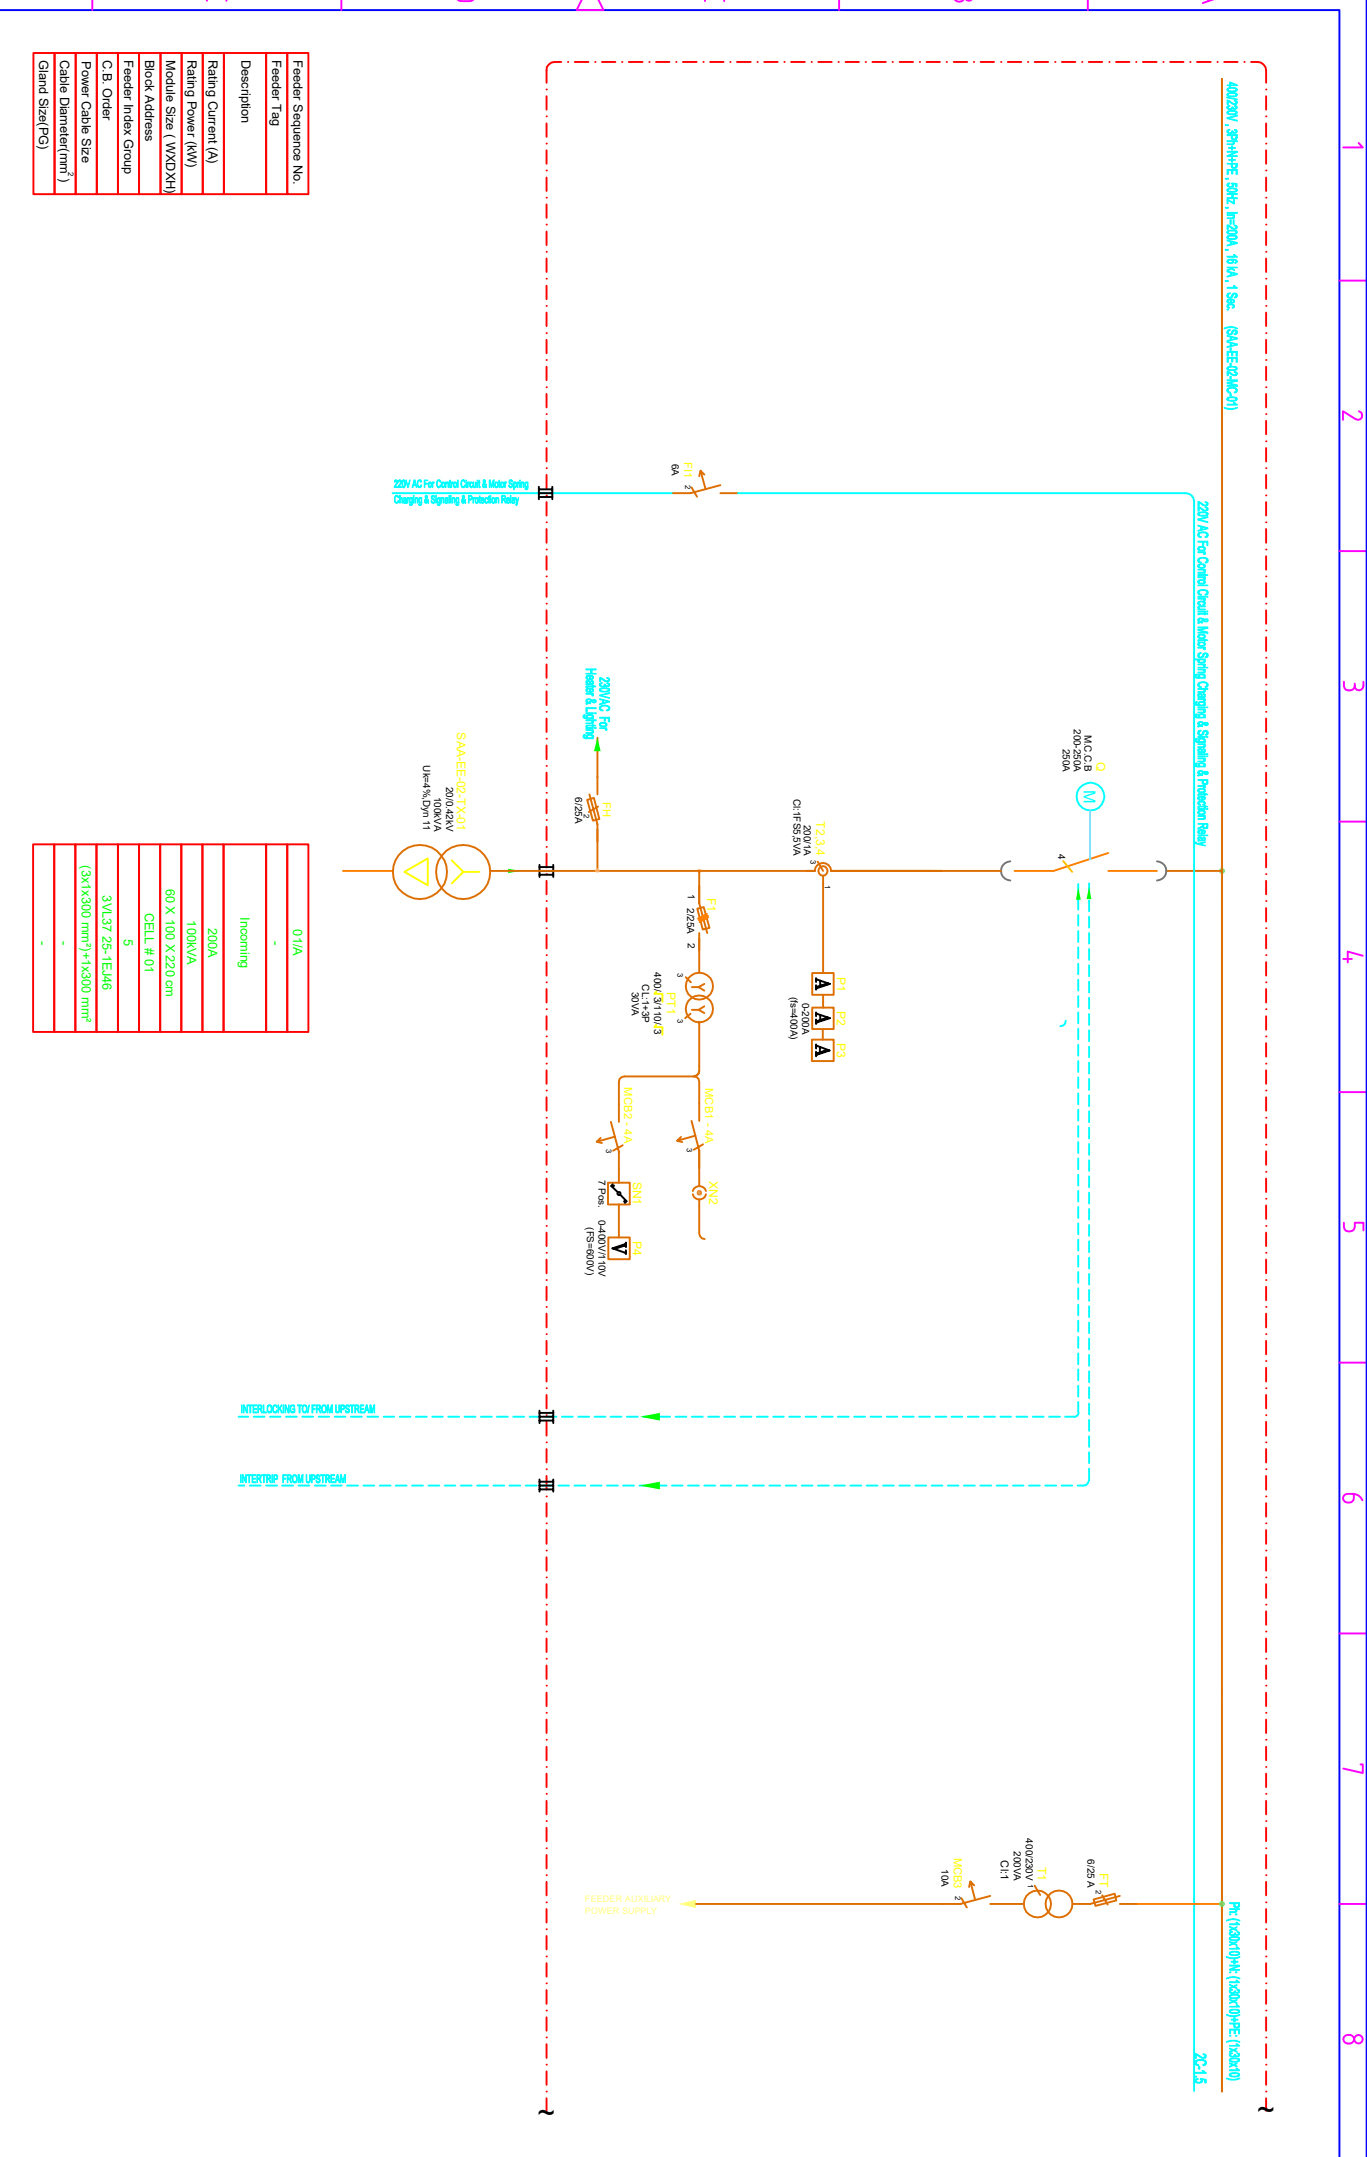

Feeder Sequence No.	
Feeder Tag	
Description	
Rating Current (A)	
Rating Power (kW)	
Module Size (WXDXH)	
Block Address	
Feeder Index Group	
C.B. Order	
Power Cable Size	
Cable Diameter(mm ²)	
Gland Size(PG)	

01/A	Incoming
	200A
	100kVA
	60 X 100 X 220 cm
	CELL # 01
	5
	3VL37 2S-1EJ46
	(3x1x300 mm ²)+1x300 mm ²

Project :	South East Zagross Cluster	CONSULTANT	CONTRACTOR	CLIENT	MANUFACTURER	Rev.	Date	Description	Designed by	Checked by	Approved by	Contractor Doc. No. :	Int. Rev.
Title :	Sharvestan And Saadar Abad Oil Fields Project	OD&CC	I.C.O.F.C	IRANSEABOCK		04	18/02/91	for As Built	N.Rahmani	E.Ezani	E.Ezani	ISC-31254-SD-04-WD-007-01	-
(MCC) - (SAA2,WELL HEADS,SAADAT ABA01 (SAA-FE-02-MC-01)						03	18/07/90	For Approve	N.Rahmani	E.Ezani	E.Ezani		Scale
Drawing Title :	SINGLE LINE DIAGRAM					02	09/07/90	For Approve	N.Rahmani	E.Ezani	E.Ezani	Client Project No. : -	1-10
						01	19/05/90	For Approve	N.Rahmani	E.Ezani	E.Ezani	Client Doc. No. : -	Sheet
						00	25/07/88	For Approve	M.Torfeh	E.Ezani	E.Ezani	Contractor Doc. No. : 287-50-55-VD-EL-SD-033-D4	3/5

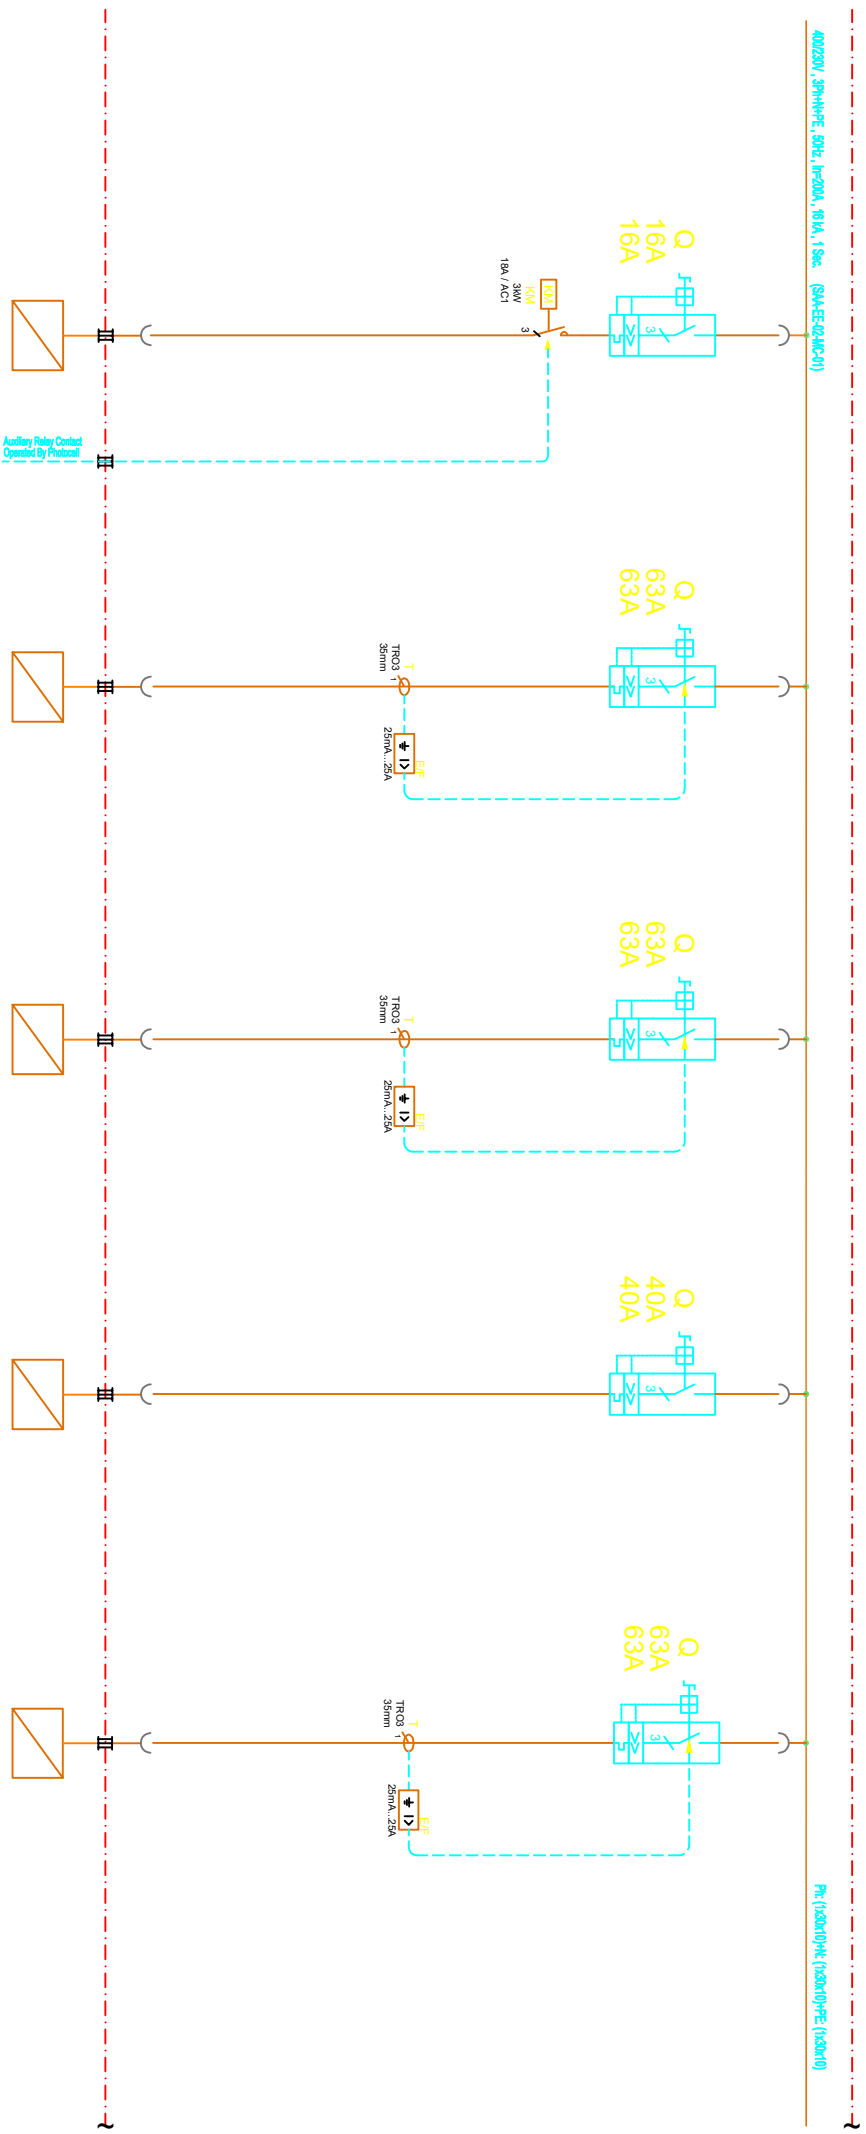

Feeder Sequence No.	Feeder Tag	Description	Rating Current (A)	Rating Power (KW)	Module Size	Block Address	Feeder Index Group	Typical Circuit No.	C.B. Order	Contactor Type	Thermal O/L relay Type	Power Cable Size	Terminal Size (SQ)	Cable Diameter(mm)	Gland Size(Pg)
1/A	---	Area Lighting	9A	5KW	200cm	2.1	4	LL1	3VL17 9E-1DA33	3RT10 15-1AP01	-	4X4 mm ²	6 mm ²	19.6 mm ²	M 20
2/A	SAA-LUP-02	UPS System	16A	8.8KW	200cm	2.4	3	LF2	3VL17 06-1DA33	-	-	4X10 mm ²	16 mm ²	21.8 mm ²	M 25
3/A	SAA-LUP-02(E)	UPS System (By Pass)	16A	8.8KW	200cm	2.5	3	LF2	3VL17 06-1DA33	-	-	4X10 mm ²	16 mm ²	21.8 mm ²	M 25
4/A	SAA2-LN-01	Lighting & Small Power For Substation	22A	9KW	200cm	2.2	2	LF1	3VL17 04-1DA33	-	-	4X4 mm ²	6 mm ²	19.6 mm ²	M 20
5/A	SAA2-LN-02	Lighting & Small Power for Chemical Injection Package Shelter	33A	14KW	200cm	2.6	3	LF2	3VL17 06-1DA33	-	-	4X16 mm ²	25 mm ²	24.9 mm ²	M 25

Project : South East Zagross Cluster Sarvestan And Saadet Abad Oil Fields Project

CONSULTANT : [Logo]

CONTRACTOR : [Logo]

CLIENT : [Logo]

MANUFACTURER : [Logo]

04	18/02/91	for As Built	N.Rahmani	E.Ezani	E.Ezani
03	18/07/90	For Approve	N.Rahmani	E.Ezani	E.Ezani
02	09/07/90	For Approve	N.Rahmani	E.Ezani	E.Ezani
01	19/05/90	For Approve	N.Rahmani	E.Ezani	E.Ezani

Iran Seabock Doc No. : ISC-37254-SD-0-4-WD-007-01


Client Project No. : -

Client Doc No. : -

Int. Rev. : -

Scale : 1 : 10

Title : 400V COMBINEDSWITCHGEAR 4MOTOR CONTROL CENTER (M.C.C) - (SAA2,WELL HEADS,SAA0AT ABA01) (SAA-EF-02-MC-01)

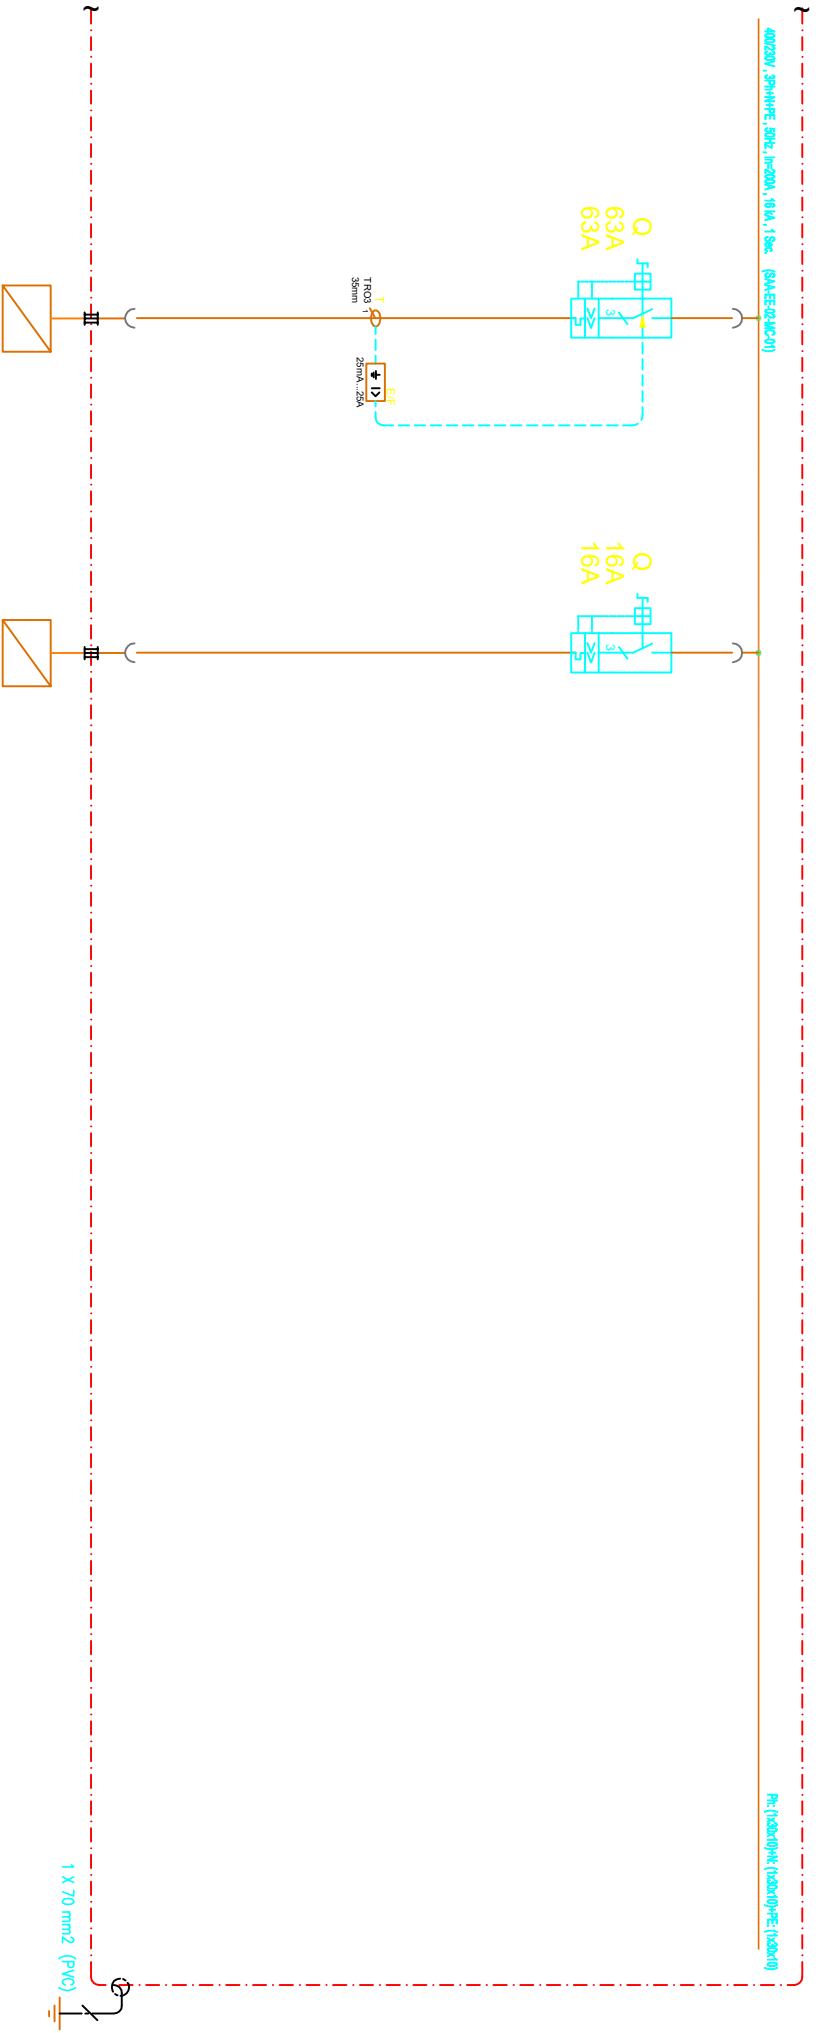


Feeder Sequence No.	6/A
Feeder Tag	-
Description	Spare
Rating Current (A)	-A
Rating Power (kW)	-kW
Module Size	20Cm
Block Address	2.7
Feeder Index Group	3
Typical Circuit No.	LF2
C. B. Order	3VL17 06-1DA33
Contactor Type	-
Thermal O/L relay Type	-
Power Cable Size	-mm ²
Terminal Size (SQ)	-mm ²
Cable Diameter (mm ²)	-
Gland Size(φ)	-

Feeder Sequence No.	7/A
Feeder Tag	-
Description	Spare
Rating Current (A)	-A
Rating Power (kW)	-kW
Module Size	20Cm
Block Address	2.3
Feeder Index Group	1
Typical Circuit No.	LF1
C. B. Order	3VL17 06-1DA33
Contactor Type	-
Thermal O/L relay Type	-
Power Cable Size	-mm ²
Terminal Size (SQ)	-mm ²
Cable Diameter (mm ²)	-
Gland Size(φ)	-

Project : South East Zagross Cluster
Sarvestan And Saadat Abad Oil Fields Project

Title : 400V COMBINED SWITCHGEAR & MOTOR CONTROL CENTER
(M.C.C) - (SAA& WELL HEADS SAADAT ABAD) (SAA-EE-02-MC-01)

Drawing Title : SINGLE LINE DIAGRAM

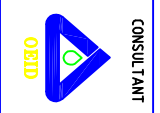

Rev.	Date	Description	Designed by	Checked by	Approved by
04	18/02/91	for As Built	N.Rahmani	E.Ezani	E.Ezani
03	18/07/90	For Approve	N.Rahmani	E.Ezani	E.Ezani
02	09/07/90	For Approve	N.Rahmani	E.Ezani	E.Ezani
01	19/05/90	For Approve	N.Rahmani	E.Ezani	E.Ezani
00	25/07/88	For Approve	M.Torfeh	E.Ezani	E.Ezani

Iran Seabock Doc. No. : ISC-37254-SD-0.4-WD-007-01

Client Project No. : -

Client Doc. No. : -

Contractor Doc. No. : 287-50-SS-VD-EL-SD-033-D4

Int. Rev. : -

Scale : 1 : 10

Sheet : 5/5